

R. B. B.

EQUIP. TYPE *F390ALIR* EXP. NO.

COL-506-1956-002

NOTICE: WHEN GOVERNMENT DRAWINGS, SPECIFICATIONS, OR OTHER DATA ARE USED FOR ANY PURPOSE OTHER THAN IN CONNECTION WITH A DEFINITELY RELATED GOVERNMENT PROCUREMENT OPERATION, THE UNITED STATES GOVERNMENT THEREBY INCURS NO RESPONSIBILITY NOR ANY OBLIGATION WHATSOEVER AND THE FACT THAT THE GOVERNMENT MAY HAVE FORMULATED, FURNISHED, OR IN ANY WAY SUPPLIED THE SAID DRAWINGS, SPECIFICATIONS, OR OTHER DATA IS NOT TO BE REGARDED BY IMPLICATION OR OTHERWISE AS IN ANY MANNER LICENSES THE HOLDER OR ANY OTHER PERSON OR CORPORATION, OR CONVEYING ANY RIGHTS OR PERMISSIONS TO MANUFACTURE, USE, OR SELL ANY PATENTED INVENTION THAT MAY IN ANY WAY BE RELATED THERETO.


THIS DOCUMENT HAS BEEN PURCHASED BY THE GOVERNMENT AND MAY BE REPRODUCED AND USED IN CONNECTION WITH ANY GOVERNMENT PROCUREMENT OR MAINTENANCE OPERATION.

* FOR INFORMATION ONLY. CONTRACTOR MAY AT HIS OPTION DEVIATE FROM THESE PROCESS DETAILS.

REVISIONS

~~*SWE APPROVAL~~
~~SYM PR10042-G~~

SYM	DESCRIPTION	DATE	APPROVAL
A ₁	A ₁ - WAS 51F4	15 OCT. 59	4242B-PC-59-A1-51 REV'D. PME

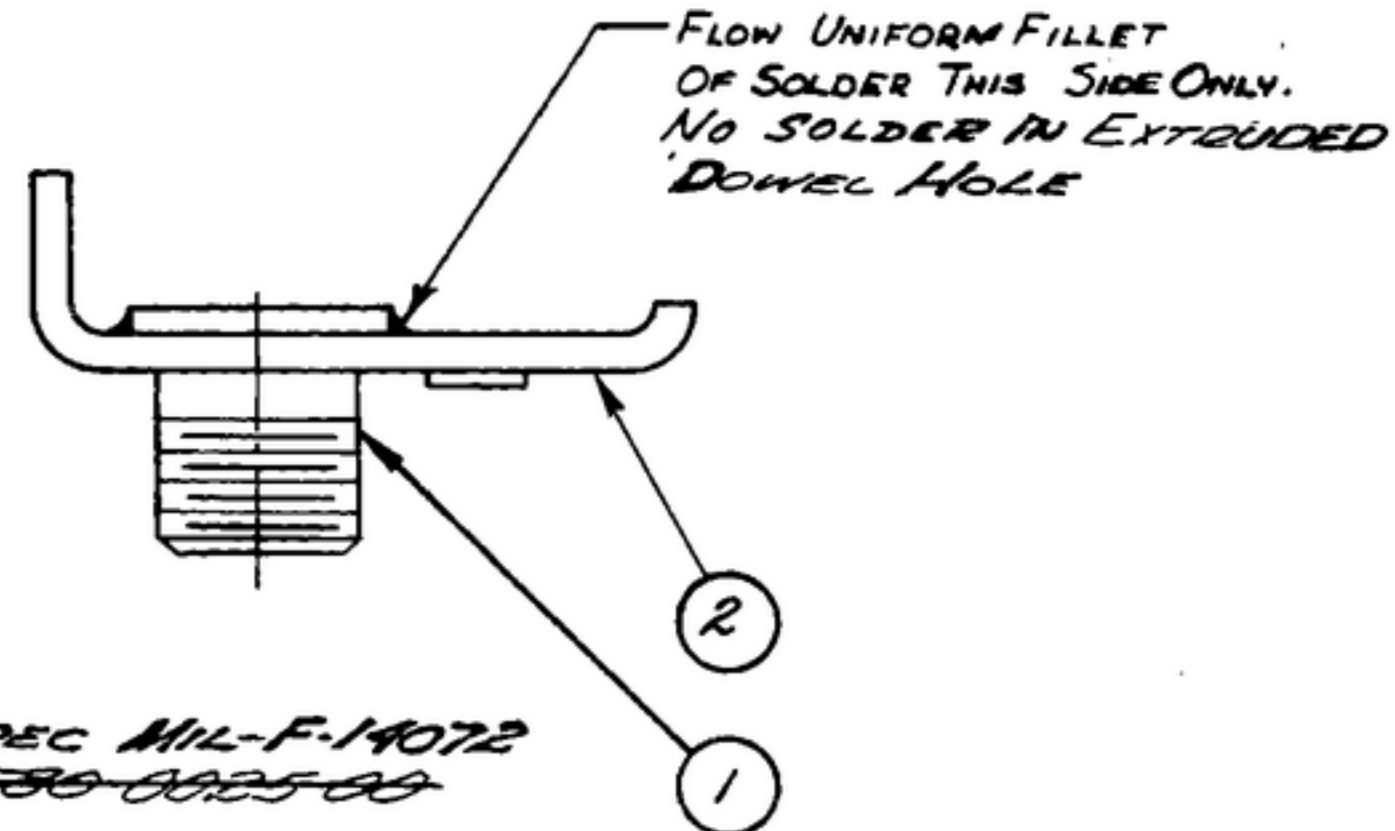

FINISH: E300 PER SPEC MIL-F-14072
~~* COLLINS 558-0025-00~~

- NOTES:
- SILVER SOLDER SHALL BE PER SPEC QQ-S-561, CLASS 4 OR 6, USING FLUX PER U.S. NAVY SPEC O-F-499. (A₁)
 - INSERT BUSHING AND SOLDER, AS SHOWN.

COLLINS PART NO.	ITEM	REQD	PART NO.	DESCRIPTION	MATL	MATL SPEC
558 0159 002	2	1	SM-B-248849	BRACKET-DIAL LOCK		
558 0160 002	1	1	SM-B-248850	BUSHING-DIAL LOCK		

LIST OF MATERIAL ~~COLLINS PART NO. 558-0161-002~~

DRAWN <i>RDS</i>		CHECKED <i>Williams</i>	APPROVED	COLLINS RADIO CO. SEAR RAPID, IOWA 1A21A-PH-51-93	BUSHING ASSY	DEPARTMENT OF THE ARMY SIGNAL CORPS ENGINEERING LABORATORIES FORT MONMOUTH NEW JERSEY SM-B-248851
UNLESS OTHERWISE SPECIFIED: DECIMAL DIMENSIONS INCLUDING HOLE SIZES MAY VARY ±.005 FRACTIONAL DIMENSIONS INCLUDING HOLE SIZES MAY VARY ±1/64 MACHINED ANGLES MAY VARY ±.1° SKEARED ANGLES MAY VARY ±.25° BROKEN ANGLES MAY VARY ±.1° ECCENTRICITY BETWEEN ANY DIAMETERS ON THE SAME CENTERLINE SHALL NOT EXCEED .010 TOTAL INDICATOR READING. ALL DIMENSIONS ARE FINISH DIMENSIONS INCLUDING APPLIED FINISH AND ARE GIVEN IN INCHES.			SIGNAL CORPS	REVIEWED <i>PME</i>		
APPLICATION			APPROVED <i>HLV</i>	DATE <i>6 DEC 1955</i>		
558-0162-002	1	SM-B-248852	SC-DL-248775	SCALE <i>2/1</i>		