


NOTICE: WHEN GOVERNMENT DRAWINGS, SPECIFICATIONS, OR OTHER DATA ARE USED FOR ANY PURPOSE OTHER THAN THAT AUTHORIZED BY THE ORIGINAL SOURCE, THE USER SHALL BE RESPONSIBLE FOR OBTAINING NECESSARY PERMISSIONS AND FOR ASSURING THAT THE DATA ARE NOT IN ANY WAY SUPPLIED BY THE GOVERNMENT. SPECIFICATIONS, OR OTHER DATA IS NOT TO BE DEEMED TO IMPLY, EITHER BY STATEMENT OR IN ANY MANNER, THE HOLDING OF ANY OTHER PATENT OR COPYRIGHT, OR THE RIGHT OF THE GOVERNMENT TO MANUFACTURE, USE, OR SELL ANY PATENTED INVENTION THAT MAY IN ANY WAY BE RELATED THERETO.

THIS DOCUMENT HAS BEEN PURCHASED BY THE GOVERNMENT AND MAY BE REPRODUCED AND USED IN CONNECTION WITH ANY GOVERNMENT PROCUREMENT OR PROCUREMENT OPERATION.

\* FOR INFORMATION ONLY. CONTRACTOR MAY AT HIS OPTION DEVIATE FROM THESE PROCESS DETAILS.

~~SWE APPROVAL~~  
SYM PR10042-9

REVISIONS			
SYM	DESCRIPTION	DATE	APPROVAL
A <sub>5</sub>	A <sub>1</sub> -REMOVED VARNISH NOTE. A <sub>2</sub> -ADDED ITEM 12. A <sub>3</sub> -REMOVED ITEM 11 (VARNISH) A <sub>4</sub> -RENUMBERED NOTES. A <sub>5</sub> -REPLACED COLLINS PART NOS. WITH SWE PART NOS.	4 NOV. 59	4242B-PC-59-AJ-51 REV'D. PME
B <sub>6</sub>	B <sub>1</sub> -ITEM 10, RN65D WAS RN20 B <sub>2</sub> -ITEM 9, RN65D WAS RN20 B <sub>3</sub> -ITEM 8, RN65D WAS RN20 B <sub>4</sub> -ITEM 7, RN65D WAS RN20 B <sub>5</sub> -ADDED /2B TO MIL-R-10509, B <sub>6</sub> -DELETED 'X' FROM PART NOS OF ITEMS 7-10	21 NOV. 1966	6-00189 REV'D. EC-2 PMB

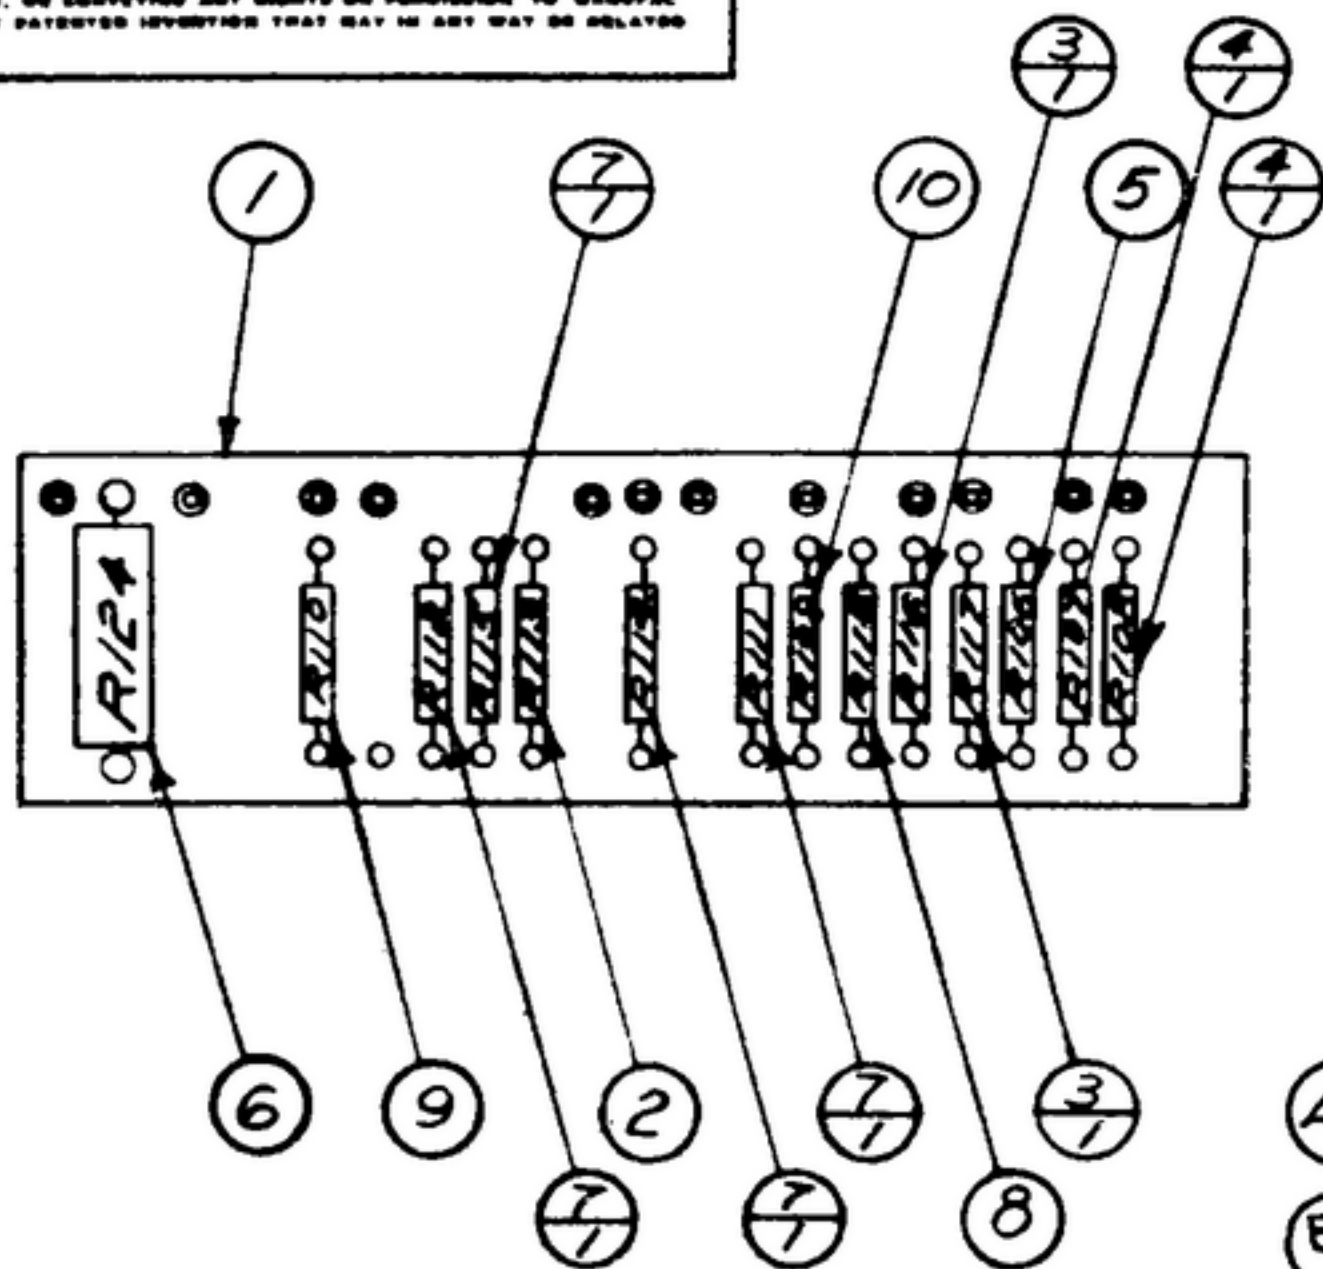

NOTES:

- A<sub>1</sub>
- A<sub>4</sub> 1. DIP SOLDER CONNECTIONS FOR RESISTORS USING SOLDER COMP 50/50 PER SPEC QQ-5-571.
- 2. IN ALL SPLIT BALLOONS, TOP FIGURE IS MATERIAL LIST ITEM INDICATOR & BOTTOM FIGURE IS QUANTITY.

SWE PART NO.	ITEM	REQD	PART NO.	DESCRIPTION	MATL	MATL SPEC	NOTES
<del>NOS/30317-9</del>	<del>12</del>	<del>A<sub>5</sub> REQ'D</del>	<del>_____</del>	<del>SOLDER, SOFT</del>			<del>1</del>
	11						
	10	1	RN65D 3921F				
	9	1	RN65D 3571F				
	8	1	RN65D 2741F				
	7	4	RN65D 2000F				
	6	1	RC32GF2R7K	RESISTOR		MIL-R-10509/2B	
	5	1		-4		MIL-R-11	
	4	2		-3			
	3	2		-2			
	2	1	SM-B283221-1	RESISTOR-FIXED			
	1	1	SM-C-249112	BOARD ASSY-CIRCUIT			

LIST OF MATERIAL COLLINS PART NO. 558 0465 002

	DRAWN <i>ECS</i>	CHECKED <i>Rh</i>	APPROVED	COLLINS RADIO CO. 14214 - PH - 51-93 SIGNAL CORPS REVIEWED <i>PME</i> APPROVED <i>HLV</i> <i>PME</i> DATE <i>28 FEB 56</i> SCALE <i>1/1</i>	BOARD ASSY - RESISTOR	DEPARTMENT OF THE ARMY SIGNAL CORPS ENGINEERING LABORATORIES FORT MONMOUTH NEW JERSEY SMB-249113
UNLESS OTHERWISE SPECIFIED: DECIMAL DIMENSIONS INCLUDING HOLE SIZES MAY VARY ± .008 FRACTIONAL DIMENSIONS INCLUDING HOLE SIZES MAY VARY ± .01 MACHINED ANGLES MAY VARY ± 1° SHEARED ANGLES MAY VARY ± .05° BROKEN ANGLES MAY VARY ± .1° ECCENTRICITY BETWEEN ANY DIAMETERS ON THE SAME CENTERLINE SHALL NOT EXCEED .010 TOTAL INDICATOR READING ALL DIMENSIONS ARE FINISH DIMENSIONS INCLUDING APPLIED FINISH AND ARE GIVEN IN INCHES			APPLICATION: <i>558-0465-002</i> + <i>SM-D-249134</i> <i>SC-DL-248715</i> NEXT ASSY: _____ USED ON: _____			