~~EQUIP. TYPE R390A/URR~~ EXP. NO.

~~COL. 540 7565 002~~

NOTICE: WHEN GOVERNMENT DRAWINGS, SPECIFICATIONS, OR OTHER DATA ARE USED FOR ANY PURPOSE OTHER THAN IN CONNECTION WITH A DEFINITELY RELATED GOVERNMENT PROCUREMENT OPERATION, THE UNITED STATES GOVERNMENT THEREBY INCURS NO RESPONSIBILITY NOR ANY OBLIGATION WHATSOEVER; AND THE FACT THAT THE GOVERNMENT MAY HAVE FORMULATED, FURNISHED, OR IN ANY WAY SUPPLIED THE SAID DRAWINGS, SPECIFICATIONS, OR OTHER DATA IS NOT TO BE REGARDED BY IMPLICATION OR OTHERWISE AS IN ANY MANNER LICENSING THE HOLDER OR ANY OTHER PERSON OR CORPORATION, OR CONVEYING ANY RIGHTS OR PERMISSION TO MANUFACTURE, USE, OR SELL ANY PATENTED INVENTION THAT MAY IN ANY WAY BE RELATED THERETO.

THIS DOCUMENT HAS BEEN PURCHASED BY THE GOVERNMENT AND MAY BE REPRODUCED AND USED IN CONNECTION WITH ANY GOVERNMENT PROCUREMENT OR MAINTENANCE OPERATION.

*FOR INFORMATION ONLY. CONTRACTOR MAY AT HIS OPTION DEVIATE FROM THESE PROCESS DETAILS.

~~*SWE APPROVAL~~
~~SYM PR10042-9~~

REVISIONS			
SYM	DESCRIPTION	DATE	APPROVAL
A_4	A_1-REMOVED SILK SCREENING NOTE 2, & SCREENING NOTATION; A_2-NOTE 1 WAS "SILK SCREENING TO BE WHITE, ETC". A_3-PBE-P WAS PBE; A_4-ADDED 3/32 DIM.	4 NOV. 59	42428-PC-59-A1-51 REV'D PME
B_1	(1) R535 & R526 RELOCATED, SCALE WAS 1/1.	2 OCT 1964	B.E.A. EDB

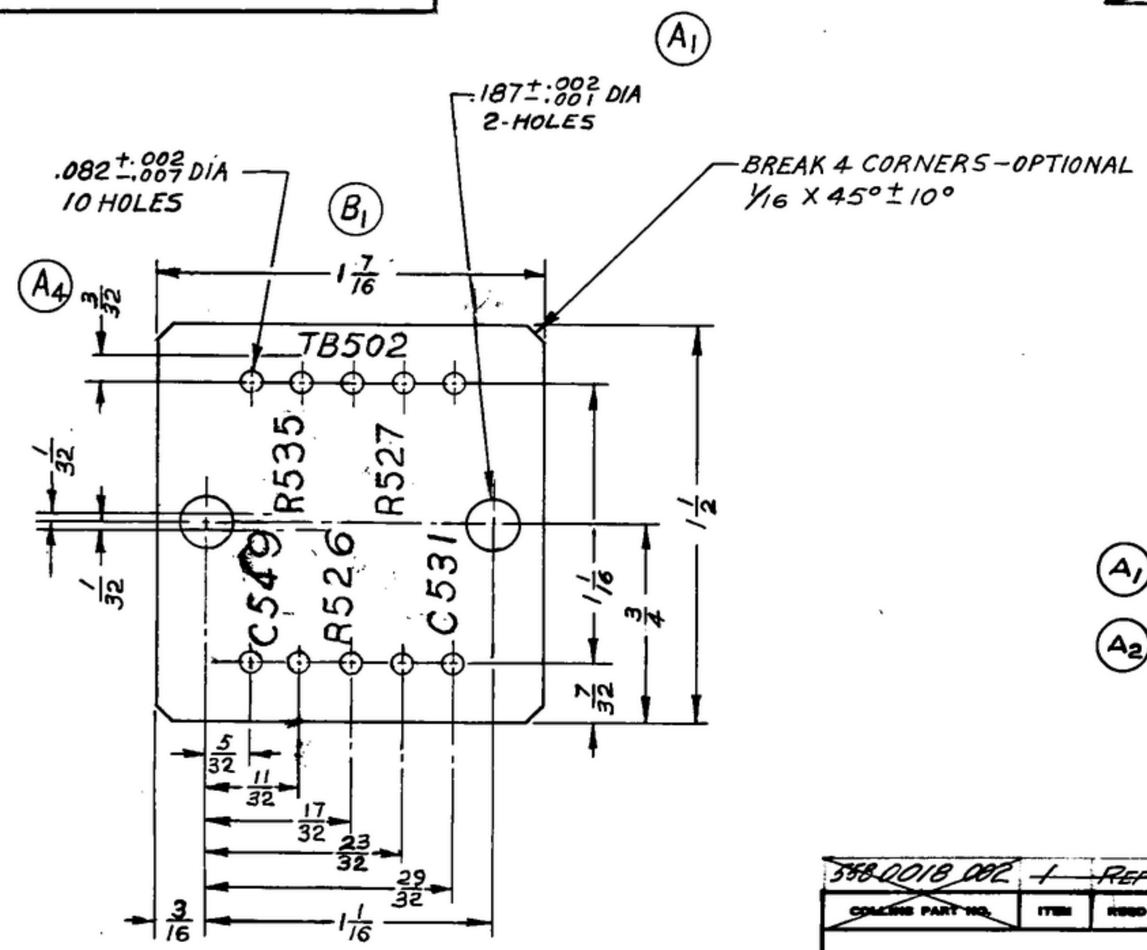

A3

PLASTIC TYPE PBE-P PER SPEC MIL-P-3115, .094 THK.

NOTES:

A1 1. ALL CHARACTERS TO BE 3/32 GOTHIC TYPE PER SPEC. MIL-M-13231, GROUP II, COLOR TO BE WHITE, COLOR CHIP NO. 27786 PER FED STD. 595. MARKING TO BE CENTRALLY LOCATED ± 1/32 UNLESS OTHERWISE SHOWN.

A2 COVER DESIGNATIONS WITH 1 COAT OF VARNISH PER MIL-V-173 TYPE II.

~~558 0018 002~~	~~1~~	~~REF~~	~~SM-B-248795~~	~~SILK SCREEN BOARD~~		
~~COLLINS PART NO.~~	ITEM	REQD	PART NO.	DESCRIPTION	MATL	MATL SPEC

LIST OF MATERIAL ~~COLLINS PART NO. 558 0352 002~~

~~558 0353 002~~	~~1~~	SM-B-249003	SC-DL-248775
~~COLLINS NO.~~	~~QTY~~	NEXT ASSY	USED ON

APPLICATION

DRAWN ECS | CHECKED [signature] | APPROVED

UNLESS OTHERWISE SPECIFIED:
DECIMAL DIMENSIONS INCLUDING HOLE SIZES MAY VARY ±.005
FRACTIONAL DIMENSIONS INCLUDING HOLE SIZES MAY VARY ±1/64
MACHINED ANGLES MAY VARY ±.1°
SHEARED ANGLES MAY VARY ±.25°
BROKEN ANGLES MAY VARY ±1.°
ECCENTRICITY BETWEEN ANY DIAMETERS ON THE SAME CENTERLINE SHALL NOT EXCEED .010 TOTAL INDICATOR READING.
ALL DIMENSIONS ARE FINISH DIMENSIONS INCLUDING APPLIED FINISH AND ARE GIVEN IN INCHES.

~~COLLINS RADIO CO.~~
~~CEDAR RAPIDS, IOWA~~
14214-PH
51-93

SIGNAL CORPS
REVIEWED PME
APPROVED HLY PME
DATE 20 DEC 55
SCALE 2/1

BOARD-TERMINAL

DEPARTMENT OF THE ARMY
SIGNAL CORPS ENGINEERING LABORATORIES
FORT MONMOUTH NEW JERSEY

SM-B-249002

PD-794—074-2071-10—A4706—[illegible]

WHEN REFERRING TO THIS DRAWING STATE DRAWING NO., APPLICABLE ISSUE SYMBOL, IF ANY, AND DATE